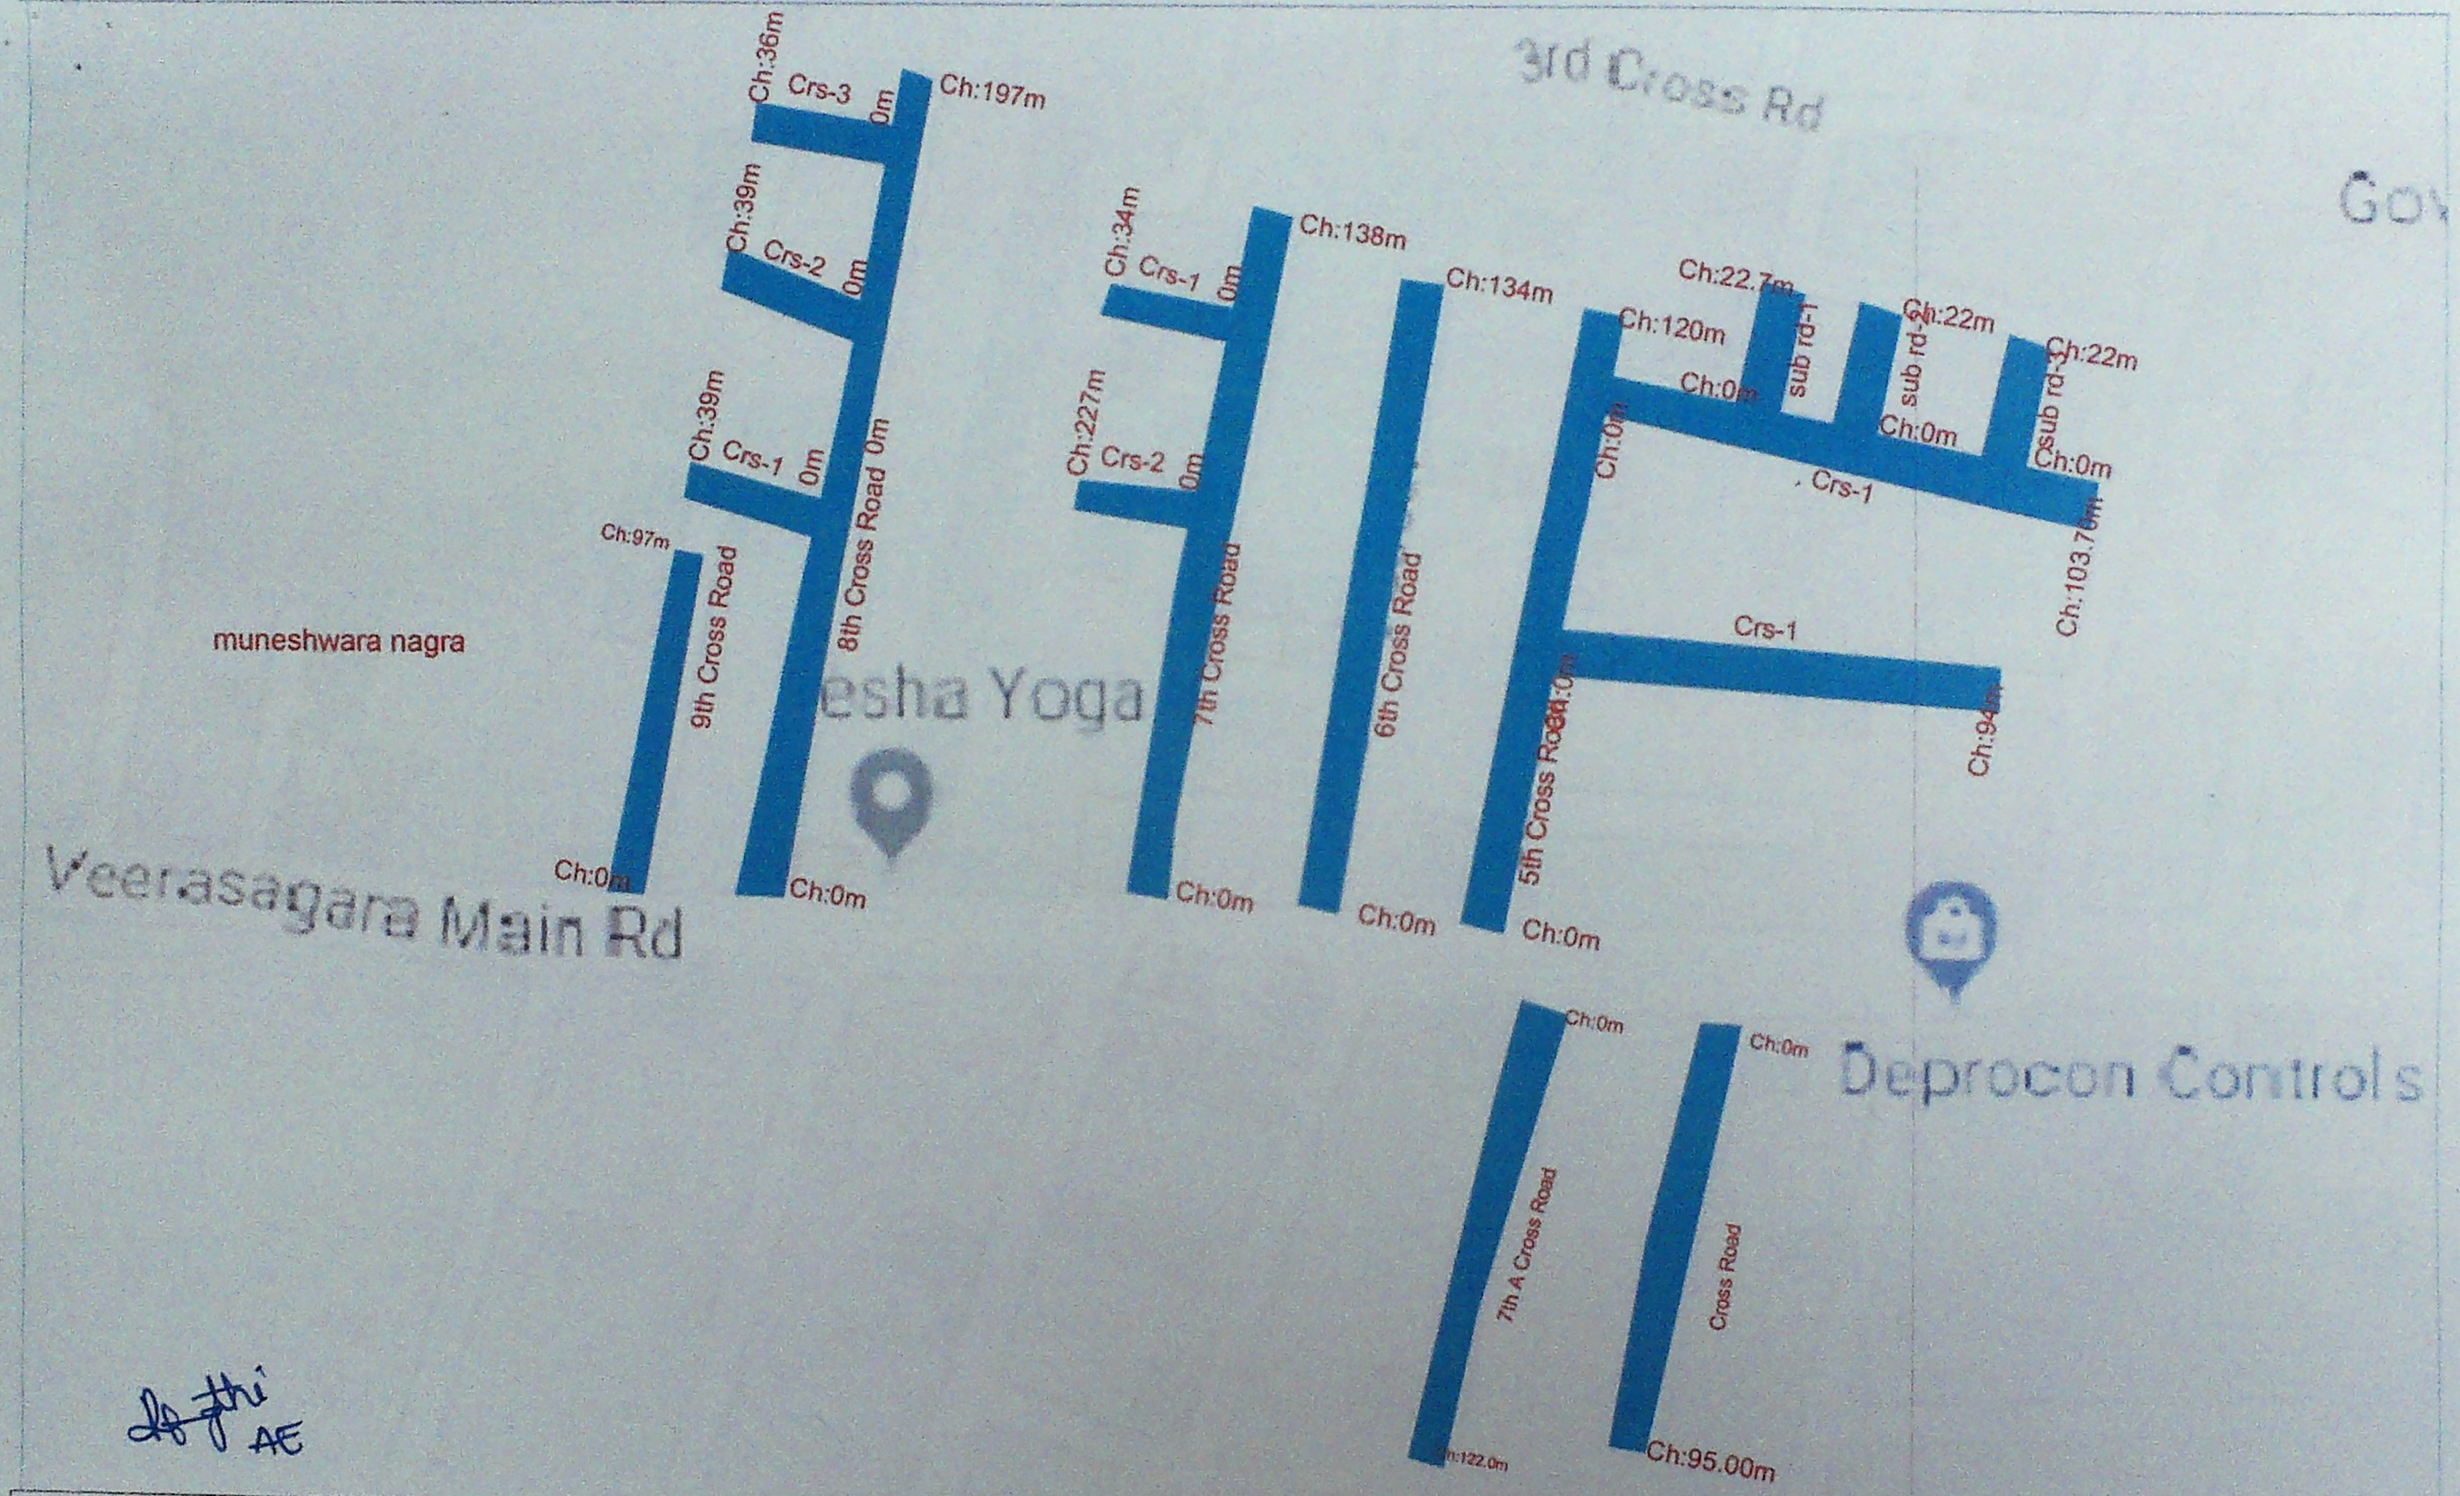

CLIENT: BRUHAT BANGALORE MAHANAGARA PALIKE	PACKAGE-1	Dwg Title: As Built plan	scale: N.T.S
			Date
		Dwg no:	Rev: R0

CLIENT: BRUHAT BANGALORE MAHANAGARA PALIKE	PACKAGE-1	Dwg Title: As Built plan	scale; N.T.S
			Date
		Dwg no:	Rev. RC

Yelahanka

Bank Of Maharashtra

4th Cross Rd

7th Crs road

Ch:321m

Swamy Vivekananda Park

4th Phase

6th Cross Rd

Ch:279m

Ch:240m

Ch:204m

Ch:182m

2nd B main Road

crs road-1

crs road-2

1st A main Road (shivarudrappa road)

1st B main Road (Kuvempu road)

2nd main Road (shivaramkaranth road)

Crs road-1

SFS 407

3rd main Road

Link Road

3A Crs beside

3A Crs Rd

Ch:0m

Ch:33.70m

Ch:95.3

Ch:40m

cross road

Ch:208m

Ch:355m

3rd main Rd

Ch:327m

2nd Main Road

1st Crs rd

Ch:33.0m

Ch:71m

1st main Road

1st Main Road

SFS 208

SFS 208

4th Phase

Ch:286m

2nd Main Road

Ch:35.70m

cross road

Park road

Asphalt Road

Concrete Road

AE

CLIENT:

BRUHAT BANGALORE MAHANAGARA PALIKE

PACKAGE-1

Dwg Title: As Built plan

Scale: N.T.S

Date

Dwg no:

Rev: R0

Ch:0m

8th A Cross Road

Ch:154m

muneshwara nagra

Ch:0m

Ch:37.50m

Ch:0m

Ch:0m

Ch:46m

Ch:40m

8th Cross Road

0m

7th Cross Road

Ch:40m

0m

6th Cross Road

Ch:38m

0m

5th Cross Road

Ch:38m

0m

4th Cross Road

Ch:41m

0m

3rd Cross Road

Ch:38m

0m

2nd Cross Road

11th Cross Road

Ch:35m

1st Cross Road

Ch:0m

Ch:285m

Asphalt Road

Concrete Road

CLIENT: RUHAT BANGALORE MAHANAGARA PALIKE	PACKAGE-1	Dwg Title: As Built plan	scale, N.T.S
			Date
		Dwg no:	Rev. R0

HDFC Life

State Bank of India Yelahanka New...

Ch:0m
4th A cross road
Ch:84.42m
Cross Rd

5th cross road
Ch:0m
Ch:82m

Ch:0m
1st main 1st cross road
Ch:33m
2nd A Main Road

3rd Main Rd

4th A Main Rd

5th Main Road

Netaji Park

12th A Main Rd

IDBI Bank

EuroKids

Ch:0m
1st main 7th cross road
Ch:133m

Shree Raghavendra Swamy Mutt

8th A Cross Rd

8th A Cross Rd

8th A Cross Rd

Asphalt Road

Concrete Road

AE

CLIENT: BRUHAT BANGALORE MAHANAGARA PALIKE	PACKAGE-1	Dwg Title: As Built plan	scale; N.T.S
			Date
		Dwg no:	Rev. R0

CLIENT: BRUHAT BANGALORE MAHANAGARA PALIKE	PACKAGE-1	Dwg Title: As Built plan Scale; N.T.S Date Dwg no:

CLIENT: BRUHAT BANGALORE MAHANAGARA PALIKE	PACKAGE-2	Dwg Title: As Built plan	scale; N.T.S Date
		Dwg no:	Rev. R0

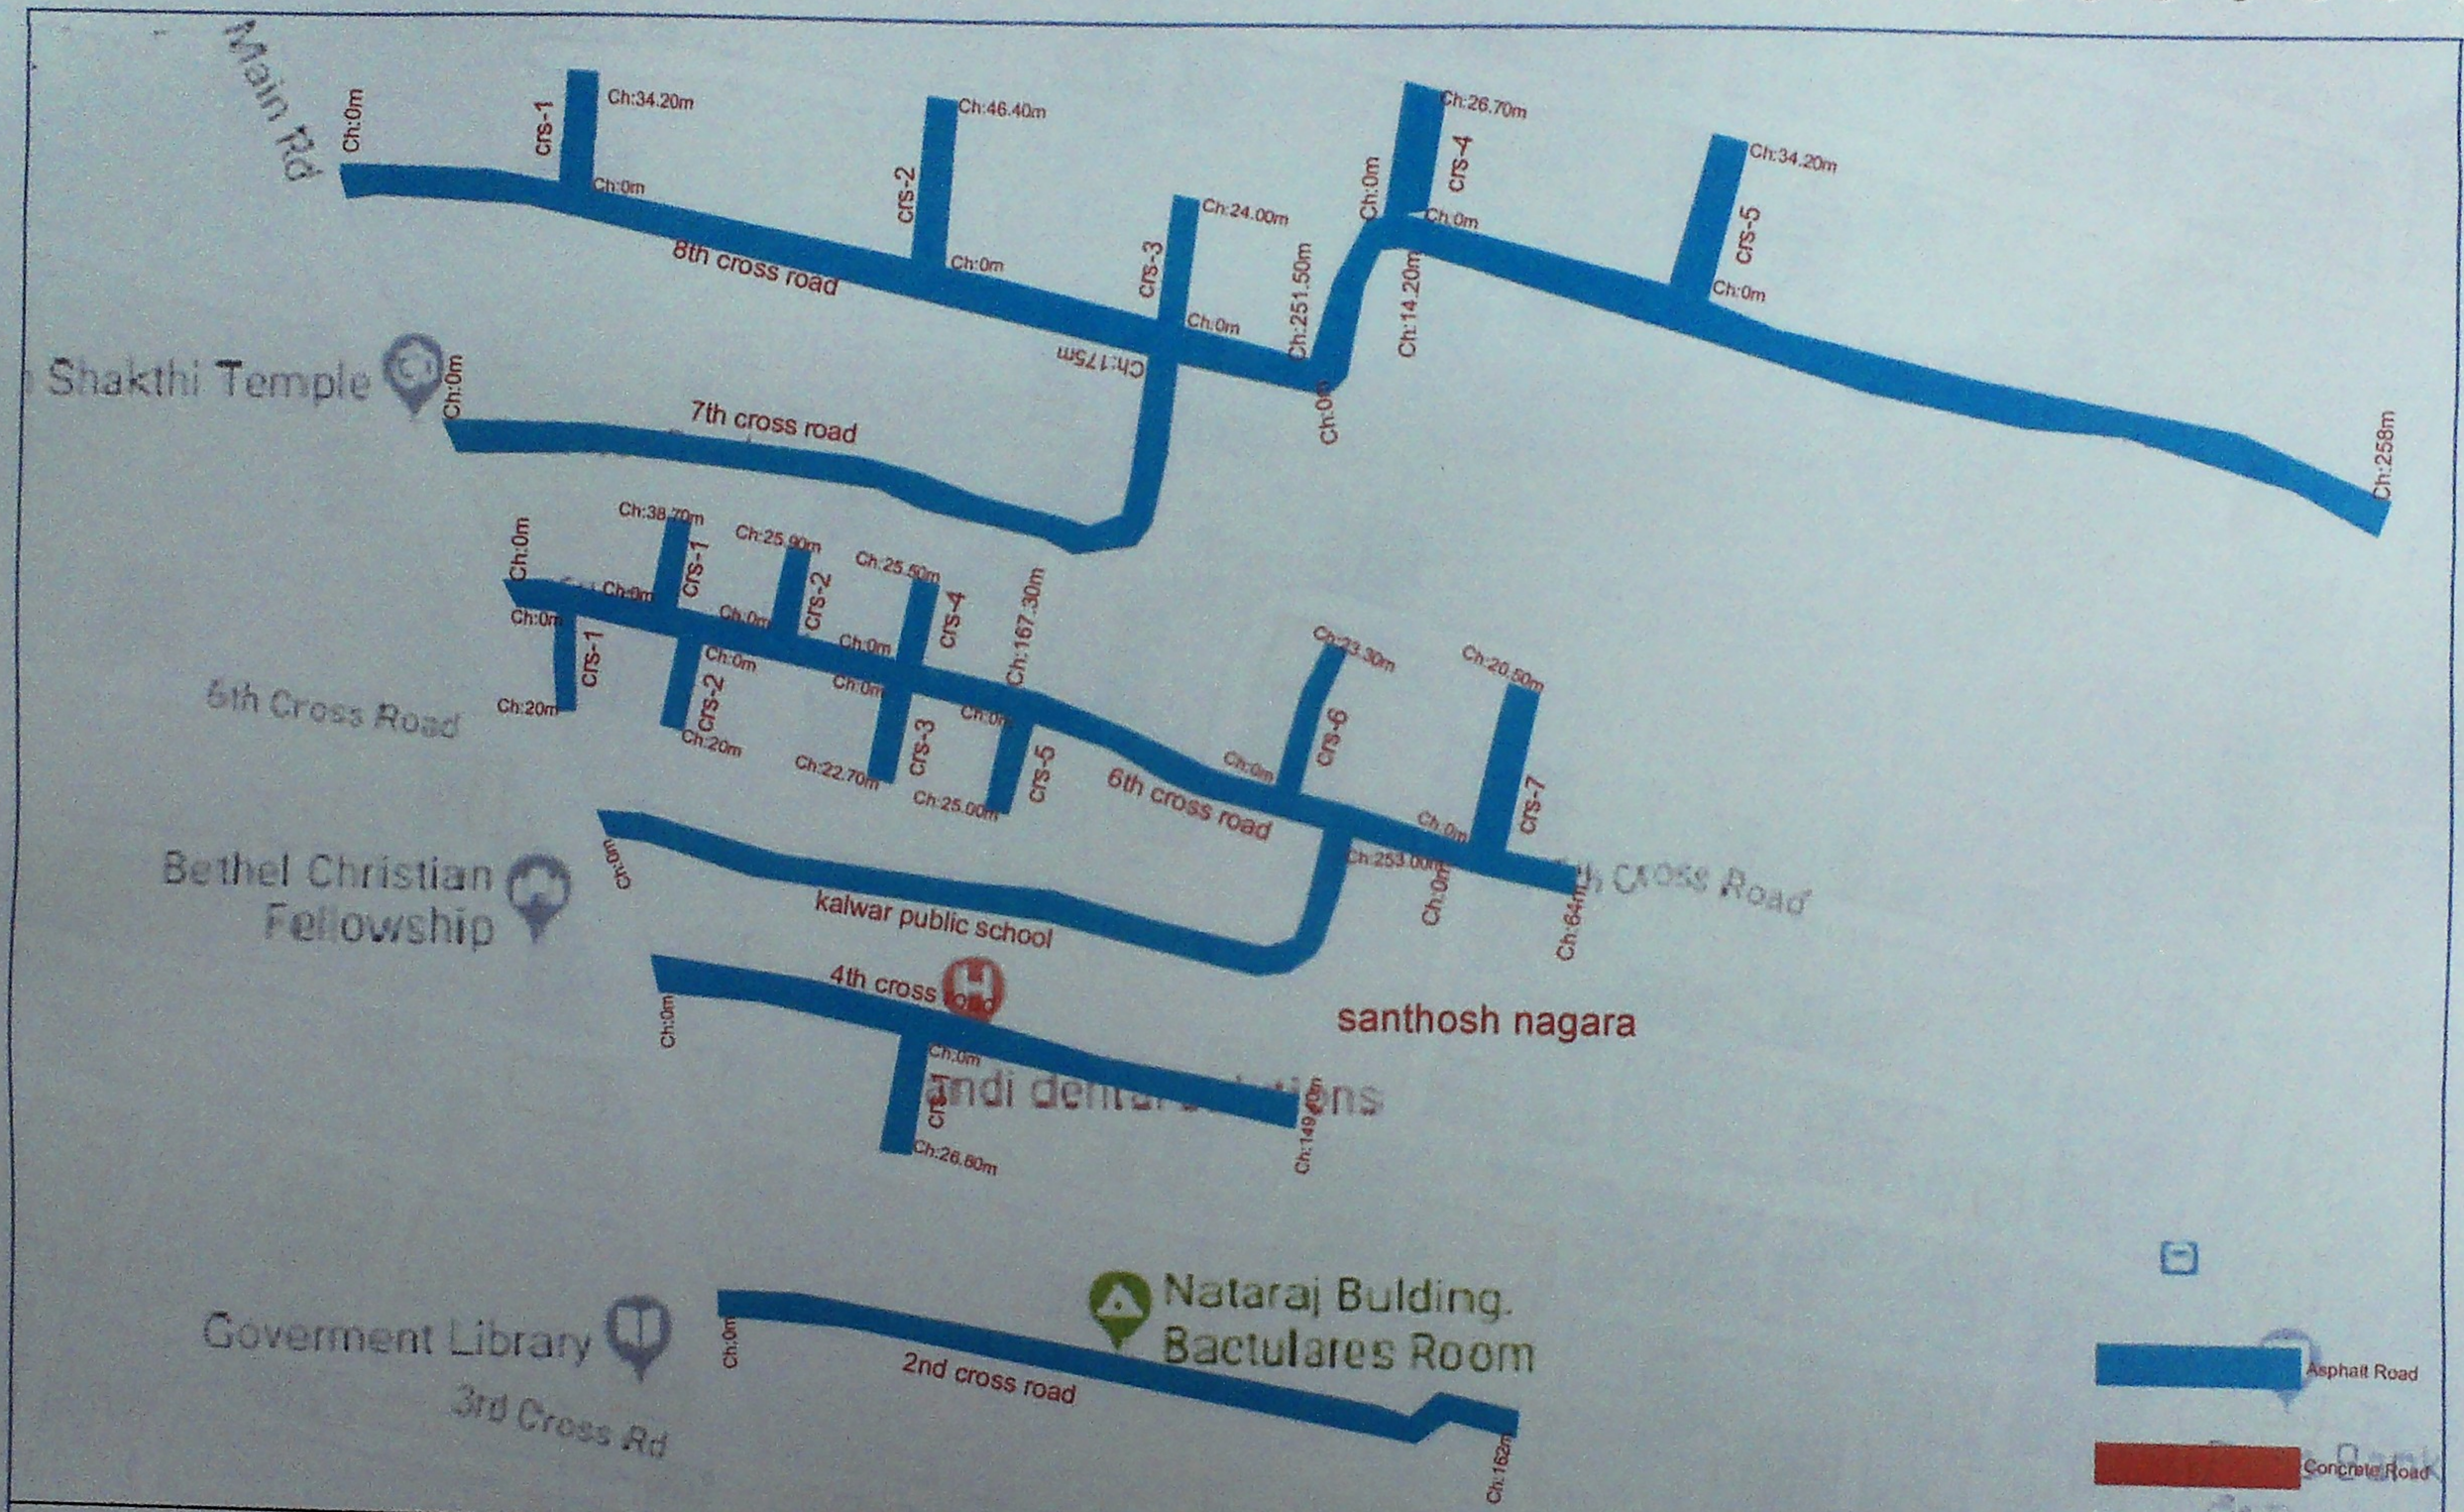

CLIENT: BRUHAT BANGALORE MAHANAGARA PALIKE	PACKAGE-2	Dwg Title: As Built plan	scale; N.T.S Date
		Dwg no:	Rev. R0

CLIENT: BRUHAT BANGALORE MAHANAGARA PALIKE	PACKAGE-3	Dwg Title: As Built plan Dwg no:	scale; N.T.S Date

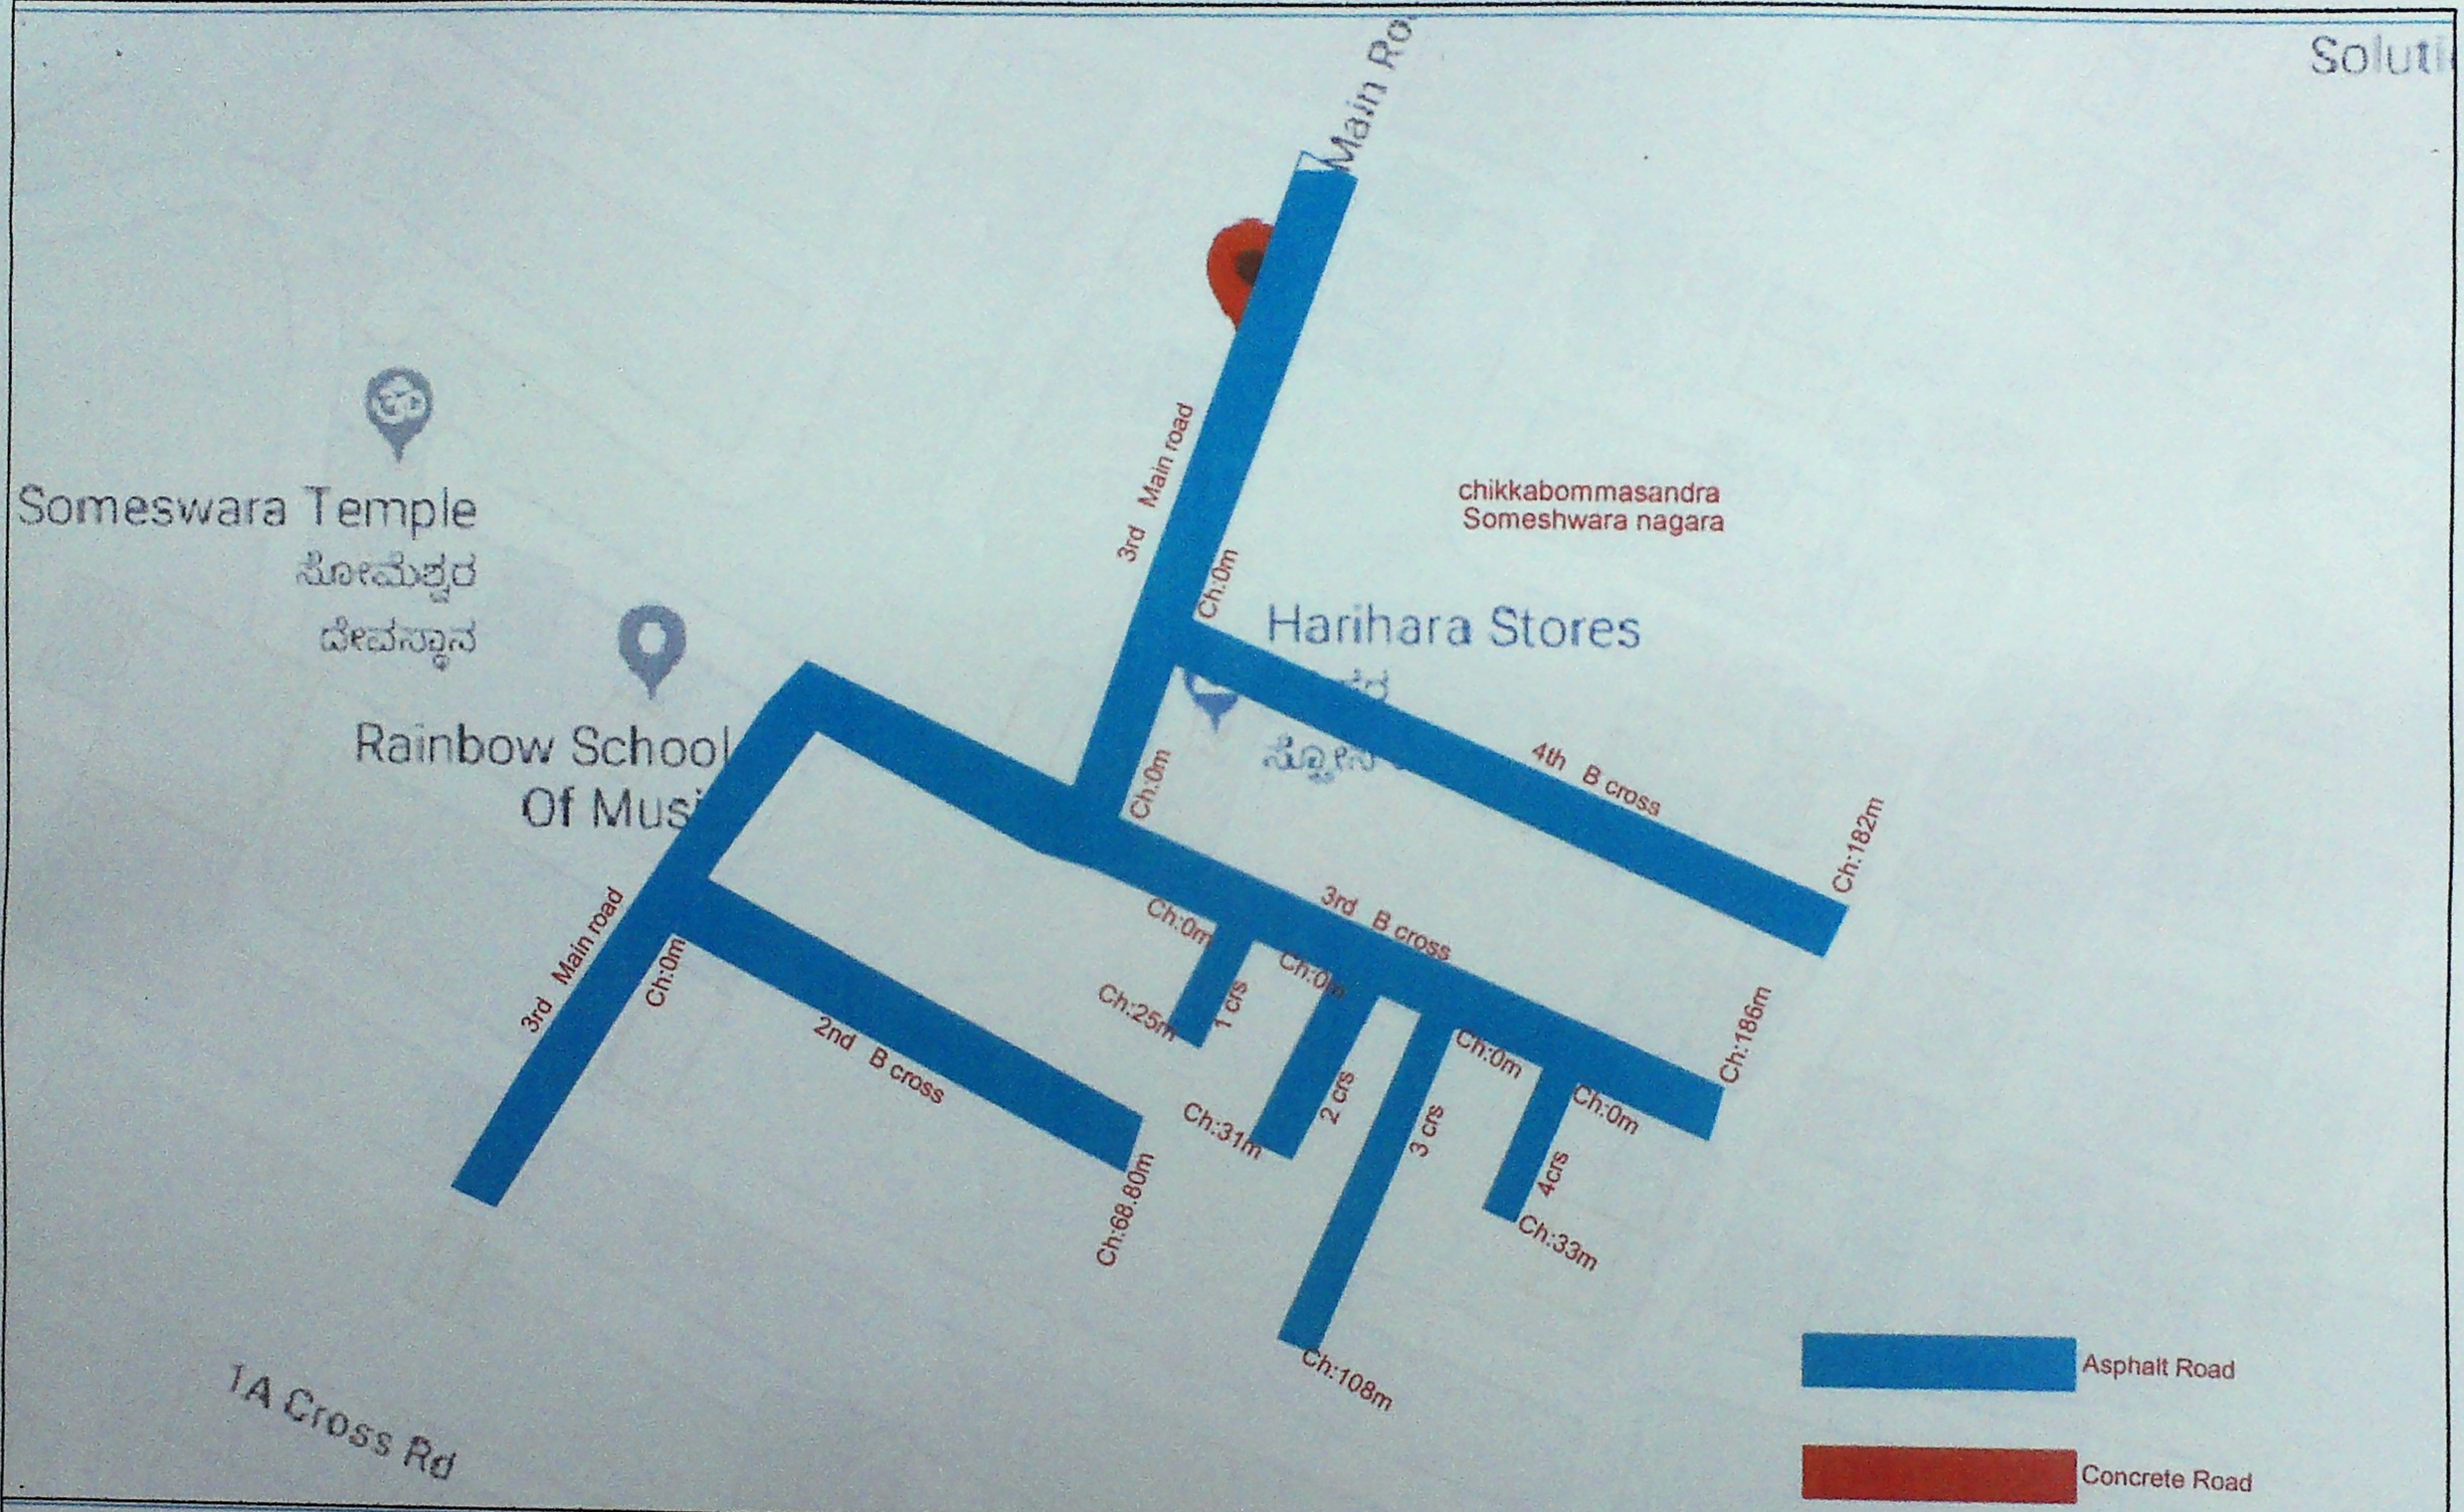

CLIENT: BRUHAT BANGALORE MAHANAGARA PALIKE	PACKAGE-3	Dwg Title: As Built plan	scale; N.T.S
			Date
		Dwg no:	Rev: R0

CLIENT: BRUHAT BANGALORE MAHANAGARA PALIKE	PACKAGE-3	Dwg Title: As Built plan Dwg no:
		scale; N.T.S Date Rev: R0

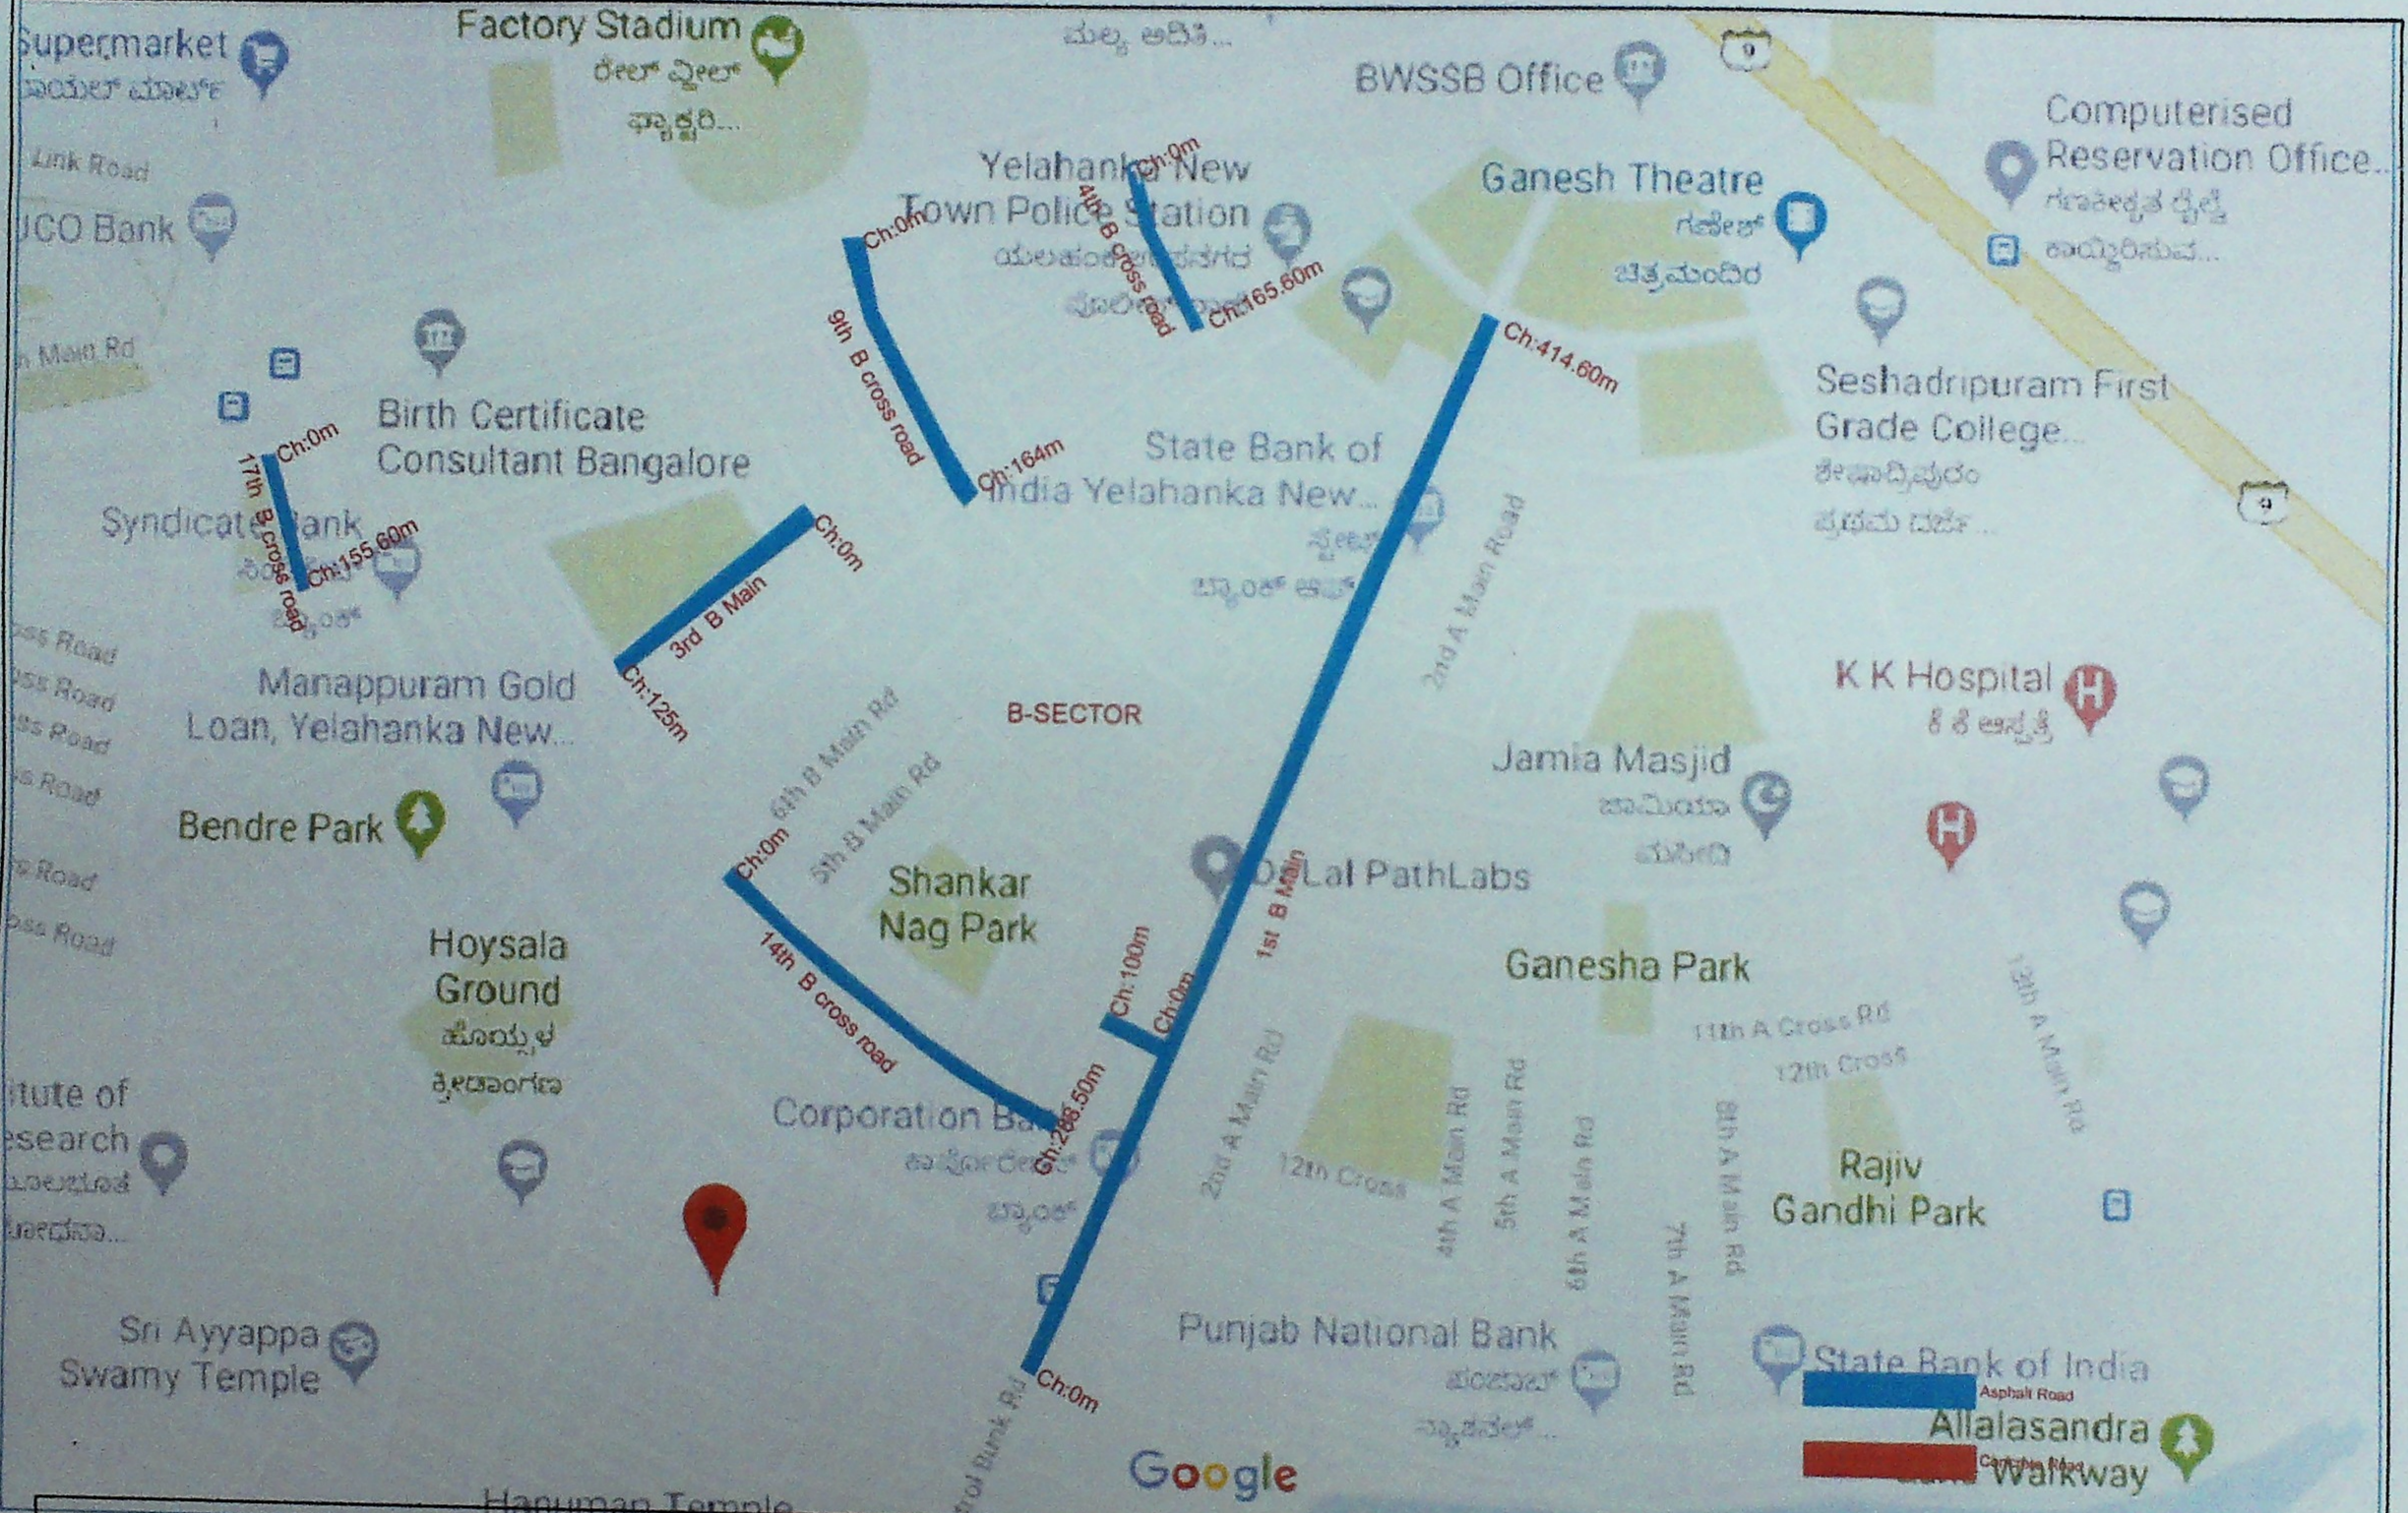

CLIENT:
BRUHAT BANGALORE MAHANAGARA PALIKE

PACKAGE-3

Dwg Title:
As Built plan

Scale; N.T.S

Date

Dwg no:

CLIENT: BRUHAT BANGALORE MAHANAGARA PALIKE	PACKAGE-3	Dwg Title: As Built plan	Scale; N.T.S
			Date
		Dwg no:	Rev. R0

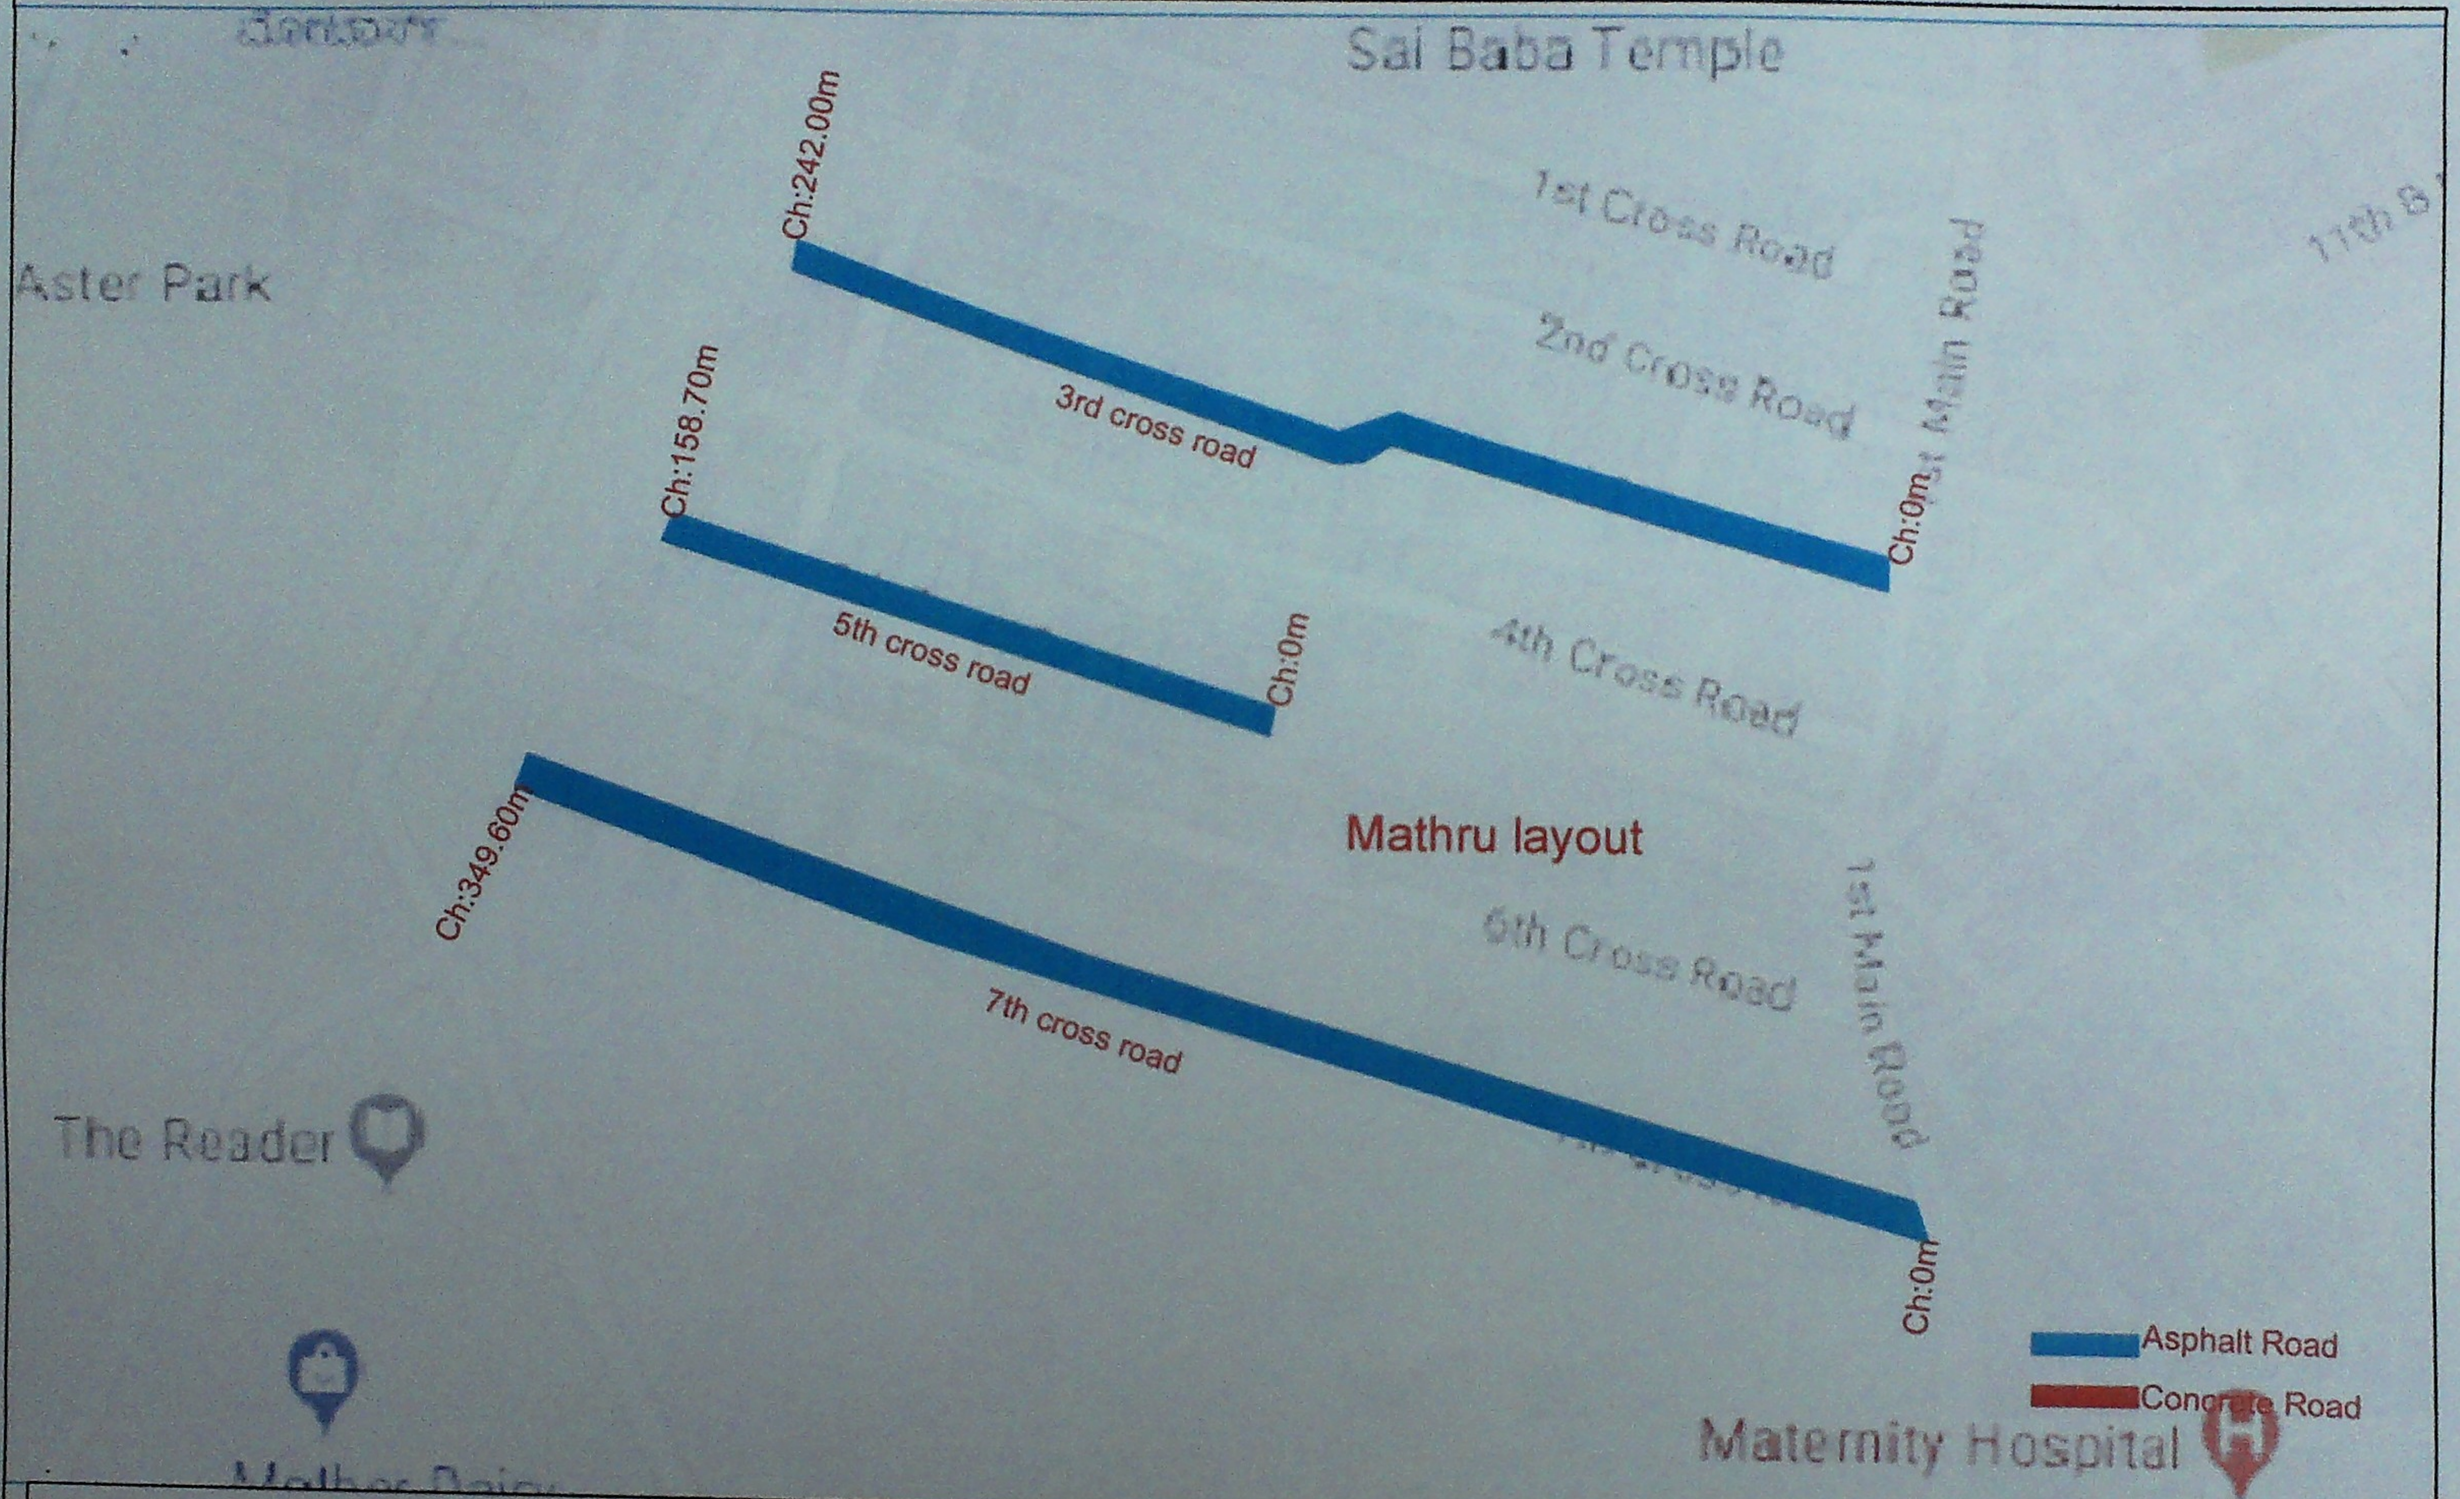

CLIENT: BRUHAT BANGALORE MAHANAGARA PALIKE	PACKAGE-4	Dwg Title: As Built plan	scale; N.T.S
			Date
		Dwg no:	Rev; RO

CLIENT: BRUHAT BANGALORE MAHANAGARA PALIKE	PACKAGE-4	Dwg Title: As Built plan	scale; N.T.S
			Date
		Dwg no:	Rev; RO

WEAR
TIONS

CLIENT: BRUHAT BANGALORE MAHANAGARA PALIKE	PACKAGE-4	Dwg Title: As Built plan	scale; N.T.S
			Date
		Dwg no:	Rev; RO

CLIENT: BRUHAT BANGALORE MAHANAGARA PALIKE	PACKAGE-4	Dwg Title: As Built plan Dwg no: scale; N.T.S Date Rev; RO

CLIENT: BRUHAT BANGALORE MAHANAGARA PALIKE	PACKAGE-4	Dwg Title: As Built plan	scale; N.T.S
			Date
		Dwg no:	Rev; R0